

LEGEND

- PROPOSED STAGE BOUNDARY
- EXISTING/FUTURE STAGE BOUNDARY
- 0.5 FINISHED SURFACE CONTOURS
- PROPOSED PROPERTY BOUNDARY
- EXISTING/FUTURE PROPERTY BOUNDARY
- MOUNTABLE KERB AND CHANNEL
- FLUSH KERB
- 63 DN63PE WATER MAIN
- 100 DN100mPVC WATER MAIN
- DN32 PE PROPERTY SERVICES
- (X) WATER FITTING NUMBER (REFER WATER FITTINGS NUMBER LEGEND)
- S EXISTING SEWER RETICULATION
- SWD STORMWATER DRAINAGE
- RWD ROOFWATER DRAINAGE
- W WATER RETICULATION
- PROPOSED RETAINING WALL
- EXISTING/FUTURE RETAINING WALL

WATER FITTINGS NUMBER LEGEND

1. 100x11.25° BEND
2. 100x22.5° BEND
3. 100x45° BEND
4. 100x90° BEND
5. 100 PRE-TAPED CONNECTOR
6. 100 HYDRANT TEE
7. 100-100 TEE
8. ISOLATING VALVE

SYMBOLS

- ISOLATION VALVE
- END CAP
- HYDRANT TEE
- DUCK-FOOT HYDRANT
- TAPER
- WATER METER

SURVEYOR'S CERTIFICATION

AS CONSTRUCTED INFORMATION SURVEYED BY LEVEL UP SURVEYING PTY LTD AND CERTIFIED BY A REGISTERED CADASTRAL SURVEYOR:

NAME: Brad Costello REG NO. 7430


SIGNATURE: DATE 19/09/25

ENGINEER'S CERTIFICATION

THIS DRAWING IS AN ACCURATE REPRESENTATION OF THE WORKS AND THE AS CONSTRUCTED DETAILS PROVIDED CONFORM WITH THE DESIGN INTENT:

NAME: Chris Hobson RPEQ 12732

SIGNATURE: DATE 22/9/2025

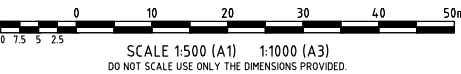

AS CONSTRUCTED

ENGINEERING CERTIFICATION					
Chris Hobson					
Registered Engineer					
Date 22/9/2025					
12732					
Registered Accreditation					



Client EASTPOINT MACKAY PTY LTD

Project DUNES, HARBOUR BEACH - STAGE 1D

Title WATER RETICULATION LAYOUT PLAN

Datum AHD PSM 118600 RL 7.152M (MGA) COORD

AS CONSTRUCTED

Project No. Drawing No. Rev B00214-CW401 2

